


- SITE NOTES:**
1. THE SITE IS LISTED ON THE TOWN OF FAIRHAVEN ASSESSORS PROPERTY RECORD CARDS AS PARCEL ID 29A-119.
  2. PROPERTY LINE AND EXISTING CONDITIONS INFORMATION WAS TAKEN FROM A FIELD SURVEY BY ZENITH LAND SURVEYORS, LLC.
  3. BRISTOL COUNTY REGISTRY OF DEEDS: DEED REFERENCE: BOOK 11365 PAGE 66
  4. THE SUBJECT PROPERTY IS LOCATED IN ZONE VE19 AND VE16, AS SHOWN ON THE FLOOD INSURANCE RATE MAP (F.I.R.M.) OF BRISTOL COUNTY, MASSACHUSETTS, MAP NUMBER 250050501F, MAP REVISED 7/7/2009.
  5. THE SITE IS NOT LOCATED IN A PRIORITY HABITAT AND ESTIMATED HABITAT AS SHOWN ON THE MASSACHUSETTS NATURAL HERITAGE ATLAS 15TH EDITION EFFECTIVE DATE AUGUST, 2021.
  6. AN ORDER OF CONDITIONS WAS ISSUED ON 3/27/2020 AND AMENDED ON 11/16/2020?? BY THE FAIRHAVEN CONSERVATION COMMISSION, DEP FILE NUMBER SE023-1302 AND CON 19-066 RECORDED IN BRISTOL COUNTY REGISTRY OF DEEDS BOOK 13500 PAGE 17 (1 OF 15).
  7. THE PROJECT IS NOT LOCATED WITHIN AN AREA OF CRITICAL ENVIRONMENTAL CONCERN (ACEC).
  8. THE SITE IS NOT LOCATED IN A ZONE II TO A PUBLIC WATER SUPPLY WELL.
  9. THE SITE IS NOT LOCATED IN AN OUTSTANDING RESOURCE WATER AREA (ORW).

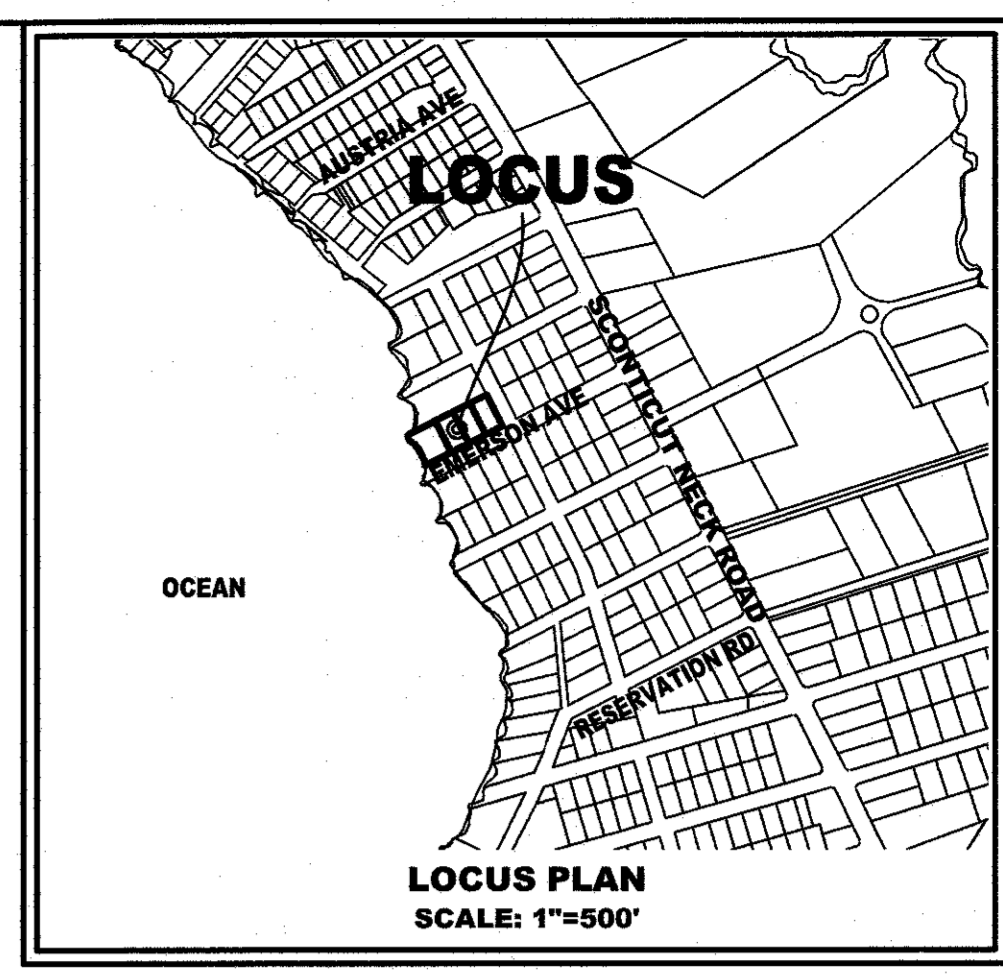


SURVEY COMPANY OF RECORD:

**ZLS**  
ZENITH LAND SURVEYORS, LLC  
1162 ROCKDALE AVENUE  
NEW BEDFORD, MA 02740  
(508) 995-0100

WILLIAM JOSEPH MCGOVERN  
39692  
REGISTERED PROFESSIONAL SURVEYOR

William McGovern  
REGISTERED LAND SURVEYOR  
DATE: October 27, 2023

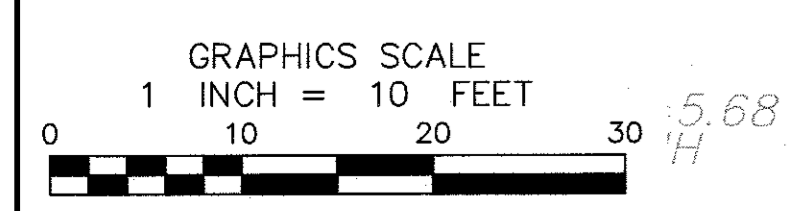

SHEET NAME:	AS-BUILT PLAN			
PROJECT SITE:	6 EMERSON AVE FAIRHAVEN, MASSACHUSETTS			
CLIENT INFO:	LAW OFFICES OF JAMESW. MARSH 128 UNION STREET NEW BEDFORD, MASSACHUSETTS			
DRAWN BY:	JR/ALB			
DESIGNED BY:				
CHECKED BY:	JLB			
APPROVED BY:	JRU			
DATE:	10/27/23			
PROJECT NUMBER:	1179-01-01			
DRAWING SCALE:	1" = 10'			
SHEET ID:	WORK			
REV.	DATE	DESCRIPTION	BY	APP.

**ZCE**  
ZENITH CONSULTING ENGINEERS, LLC  
3 MAIN STREET LAKEVILLE, MA 02347  
PHONE: (508) 947-4208

P.E. STAMP