
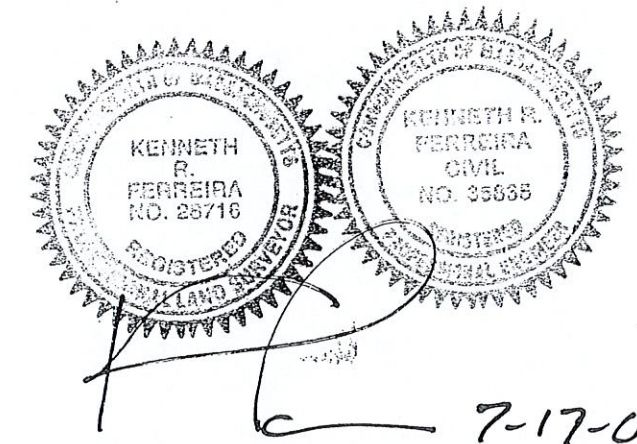
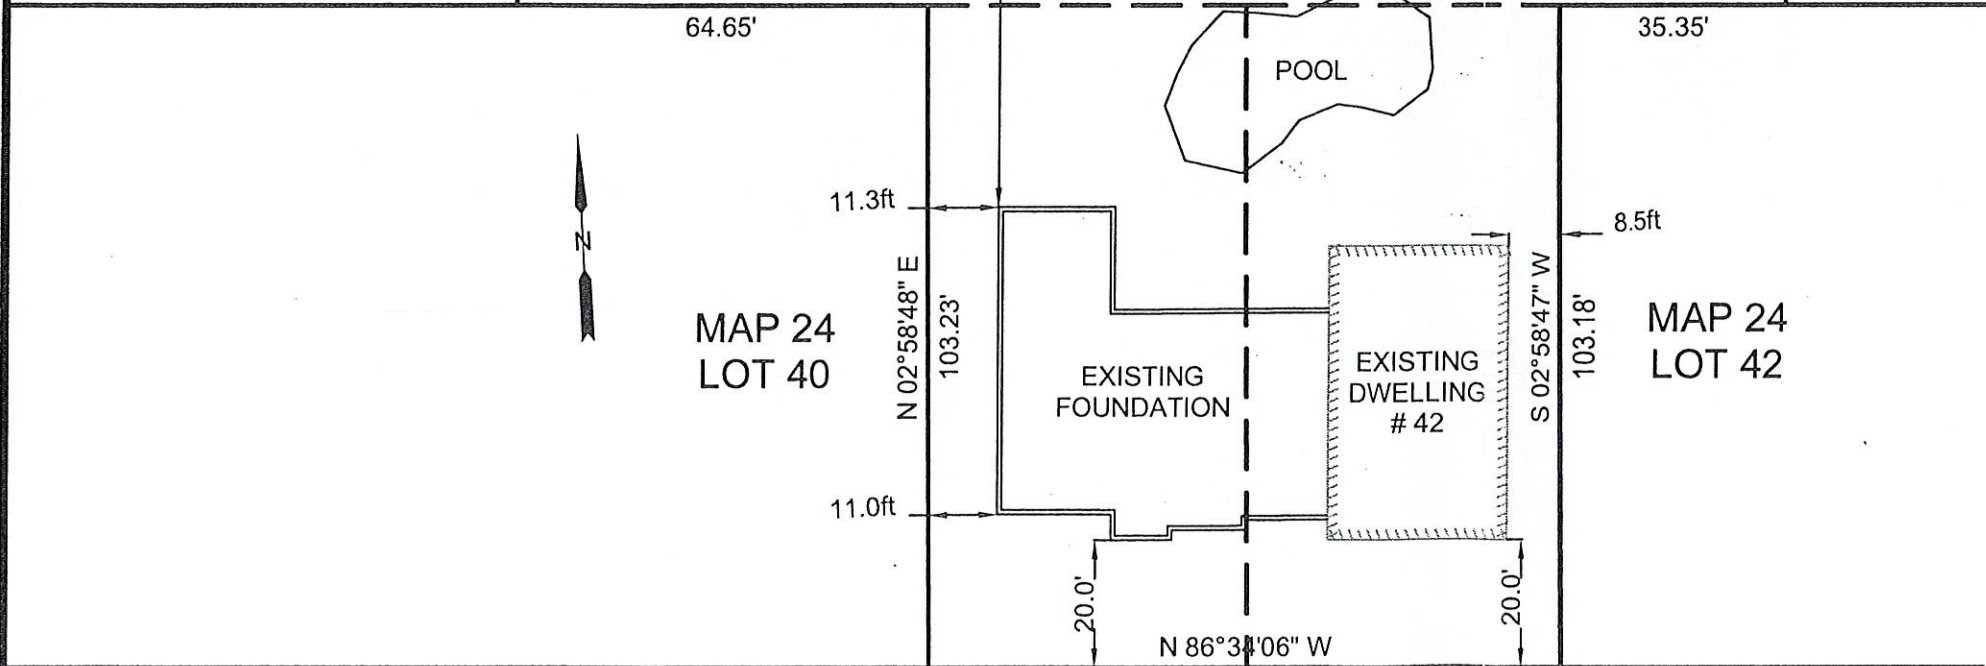


NOTES:  
 REFER TO PLAN BOOK 110, PAGE 7.  
 REFER TO PLAN BOOK 127, PAGE 123.  
 REFER TO L.C. PLAN 11289A AND CERT #16108.  
 REFER TO FAIRHAVEN ASSESSORS MAP 24.

ASH STREET

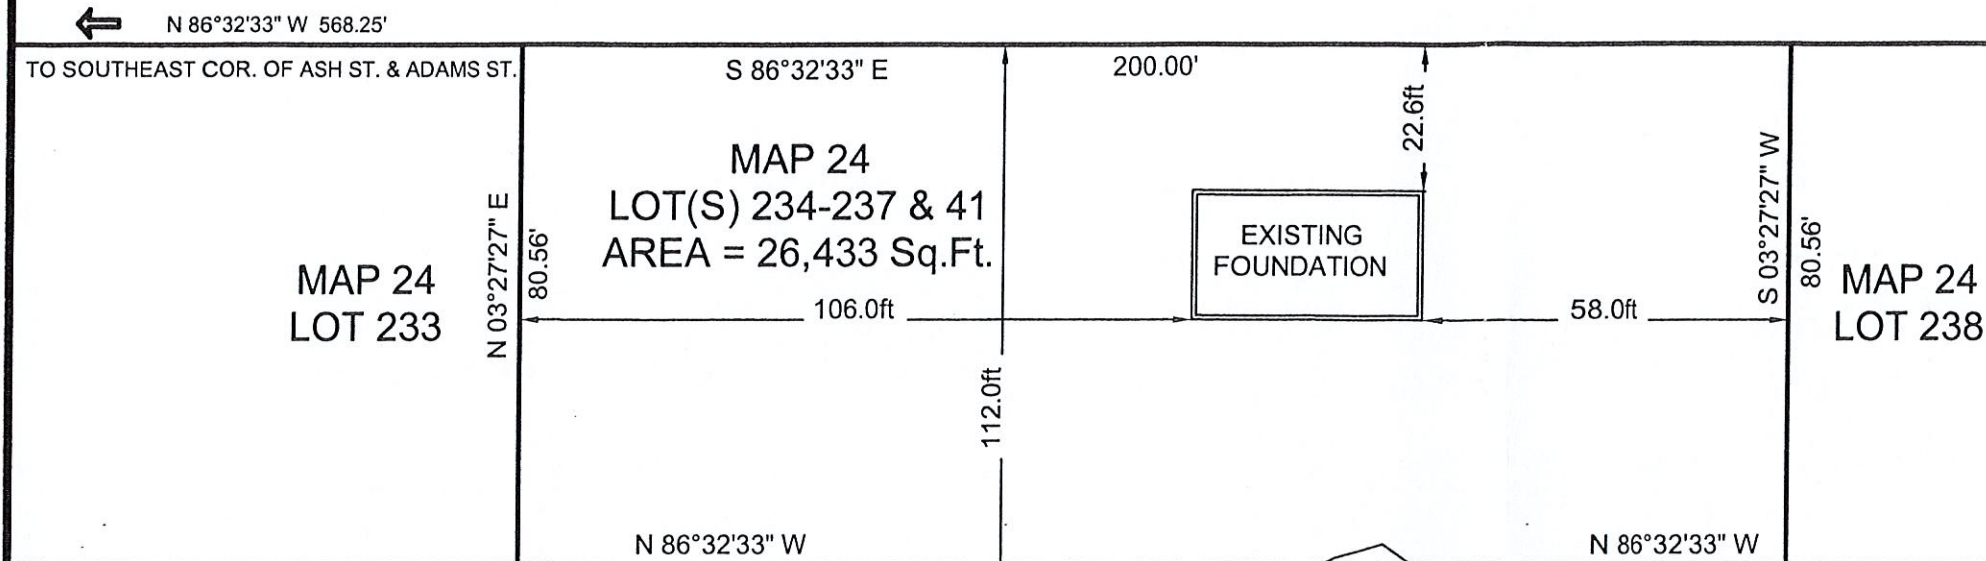

KENNETH R. FERREIRA, R.L.S., P.E. DATE

REVISED DATE: 7/17/2008 - ADDED POOL HOUSE FOUNDATION

FOUNDATION AS-BUILT PLAN

ALLEN & CYNTHIA DAYS

42 BELLEVUE STREET

FAIRHAVEN, MA

KENNETH R. FERREIRA ENGINEERING, INC. SUITE 2S, 46 FOSTER STREET NEW BEDFORD, MASSACHUSETTS 02740 TEL: (508) 992-0020 - FAX: (508) 992-3374	DATE: 7/11/2008	DESIGNED BY:
	SCALE: 1" = 30'	CHECKED BY: KRF
	DRAWN BY: KJS	JOB No: SE 43192